

Town and Country Planning Act 1990

The Punch Bowl Tree Preservation Order 2016

The Ribble Valley Borough Council, in exercise of the powers conferred on them by section 198 of the Town and Country Planning Act 1990 make the following Order—

### **Citation**

1. This Order may be cited as the Punch Bowl Tree Preservation Order 2016.

### **Interpretation**

- 2.— (1) In this Order “the authority” means the Ribble Valley Borough Council.
- (2) In this Order any reference to a numbered section is a reference to the section so numbered in the Town and Country Planning Act 1990 and any reference to a numbered regulation is a reference to the regulation so numbered in the Town and Country Planning (Tree Preservation)(England) Regulations 2012.

### **Effect**

- 3.— (1) Subject to article 4, this Order takes effect provisionally on the date on which it is made.

(2) Without prejudice to subsection (7) of section 198 (power to make tree preservation orders) or subsection (1) of section 200 (tree preservation orders: Forestry Commissioners) and, subject to the exceptions in regulation 14, no person shall—


- (a) cut down, top, lop, uproot, wilfully damage, or wilfully destroy; or
- (b) cause or permit the cutting down, topping, lopping, uprooting, wilful damage or wilful destruction of,

any tree specified in the Schedule to this Order except with the written consent of the authority in accordance with regulations 16 and 17, or of the Secretary of State in accordance with regulation 23, and, where such consent is given subject to conditions, in accordance with those conditions.

### **Application to trees to be planted pursuant to a condition**

4. In relation to any trees identified in the first column of the Schedule by the letter T and G, being a tree to be planted pursuant to a condition imposed under paragraph (a) of section 197 (planning permission to include appropriate provision for preservation and planting of trees), this Order takes effect as from the time when the tree is planted.

Dated this 13<sup>th</sup> of April 2016

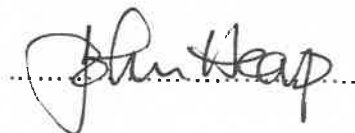


Signed on behalf of the Ribble Valley Borough Council

Authorised by the Council to sign in that behalf]

**CONFIRMATION OF ORDER**

This Order was confirmed by Ribble Valley Borough Council subject to the modifications indicated by the changes to the schedule on the 28<sup>th</sup> of September 2016

Signed on behalf of the Ribble Valley Borough Council

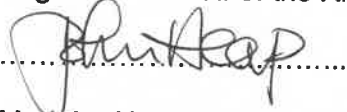.....

Mr John Heap, Director of Community Services  
Authorised by the Council to sign in that behalf]

## SCHEDULE

### Specification of trees

#### Trees specified individually

(encircled in black on the map)

<i>Reference on map</i>	<i>Description</i>	<i>Situation</i>
[T1]	[Beech]	[the Punch Bowl Inn, Hurst Green, Ribble Valley]
<del>[T2]</del>	<del>[Ash]</del>	
<del>[T3]</del>	<del>[Ash]</del>	
[T4]	[Oak]	
[T5]	[Oak]	
<del>[T6]</del>	<del>[Ash]</del>	

NOTE – T2/T3/T6  
excluded from  
modified order due  
to condition

#### Trees specified by reference to an area

(within a dotted black line on the map)

<i>Reference on map</i>	<i>Description</i>	<i>Situation</i>
[none]	[none]	[none]

#### Groups of trees


(within a broken black line on the map)

<i>Reference on map</i>	<i>Description (including number of trees of each species in the group)</i>	<i>Situation</i>
[G1]	[Lime, Beech + Sycamore]	[the Punch Bowl Inn, Hurst Green, Ribble Valley]

#### Woodlands

(within a continuous black line on the map)

<i>Reference on map</i>	<i>Description</i>	<i>Situation</i>
[none]	[none]	[none]

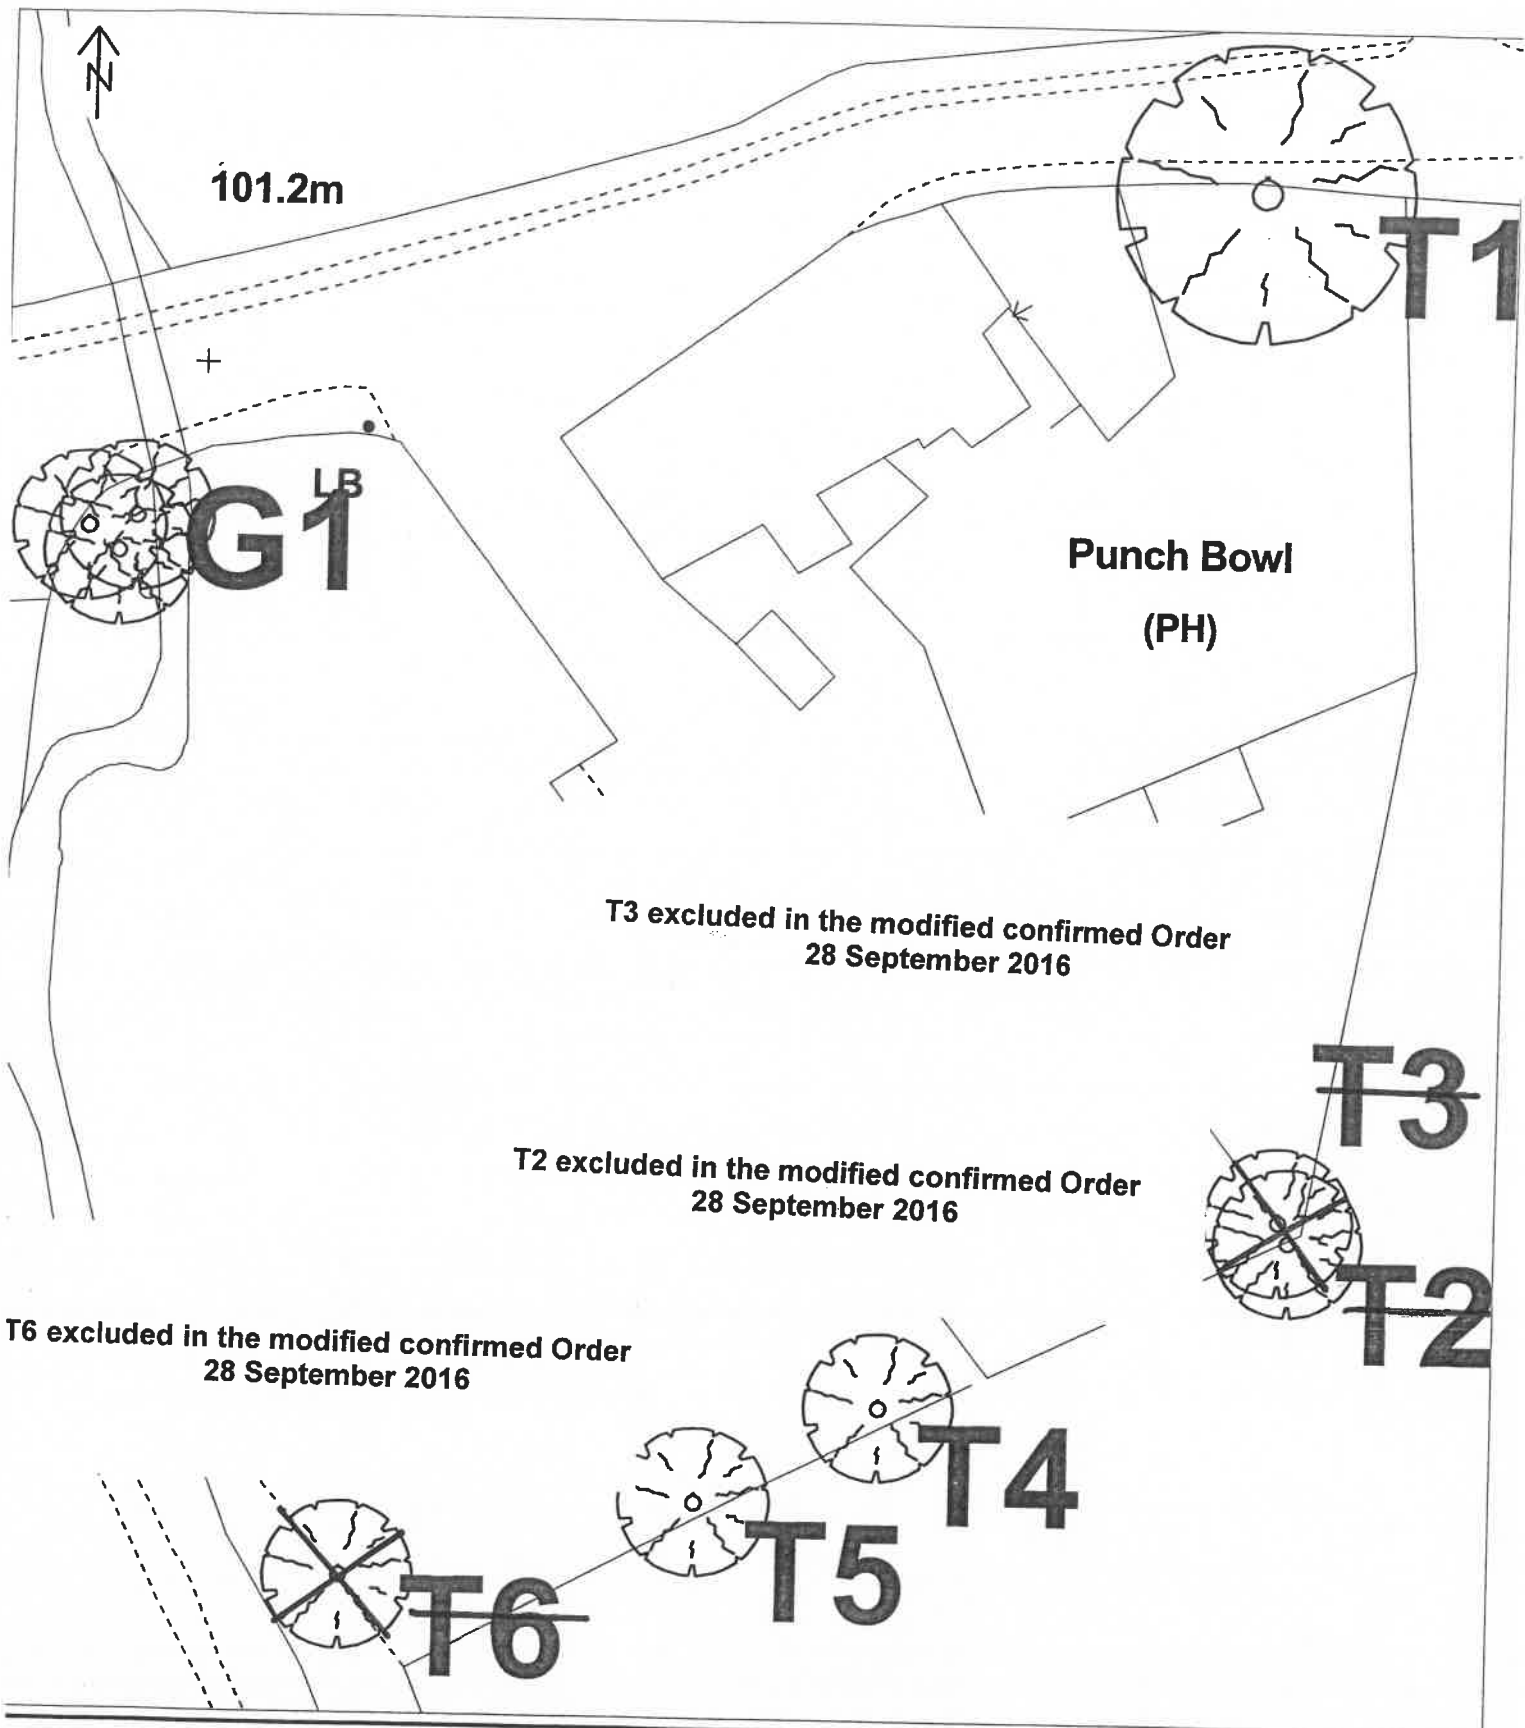

101.2m

**G1**<sup>LB</sup>

**Punch Bowl  
(PH)**

**T3 excluded in the modified confirmed Order  
28 September 2016**

**T2 excluded in the modified confirmed Order  
28 September 2016**

**T6 excluded in the modified confirmed Order  
28 September 2016**

~~**T3**~~

~~**T2**~~

**T4**

**T5**

~~**T6**~~

**RIBBLE VALLEY BOROUGH COUNCIL TREE PRESERVATION ORDER NO./NOS. 7/3/19/198**  
**TOWN & COUNTRY PLANNING ACT 1990**  
**TOWN & COUNTRY PLANNING (TREES) REGULATIONS 1999**

**LOCATION: THE PUNCH BOWL INN**

**PARISH: HURST GREEN**

**OS SHEET: SD6737NW**

© Crown Copyright. All rights reserved.  
 Ribbles Valley Borough Council. Licence No.100018641 13 April 2016  
 for reference purposes only. No further copies may be made.

**Scale 1:500**